

Suite 2400
H. W. Oliver Building
535 Smithfield Street
Pittsburgh, PA 15222

Tel: (412) 261-0660
Fax: (412) 261-7071



for:
Phipps Conservatory and
Botanical Gardens
One Schenley Park Drive,
Pittsburgh, PA 15213


Date:	
Drawn By:	GMF
Checked By:	KJR
Approved By:	RAJ
File Label:	
Schematic Design Phase:	<input type="checkbox"/>
Design Development Phase:	<input type="checkbox"/>
Construction Documentation Phase:	<input checked="" type="checkbox"/>
Progress Drawing:	<input checked="" type="checkbox"/>
Released for Bid:	<input type="checkbox"/>
Released for Construction:	<input type="checkbox"/>
Record Drawing:	<input type="checkbox"/>

Revision Schedule		
No.	Date	Description

E201

PROJECT NUMBER: 07036.01

© 2008 THE DESIGN ALLIANCE ARCHITECTS

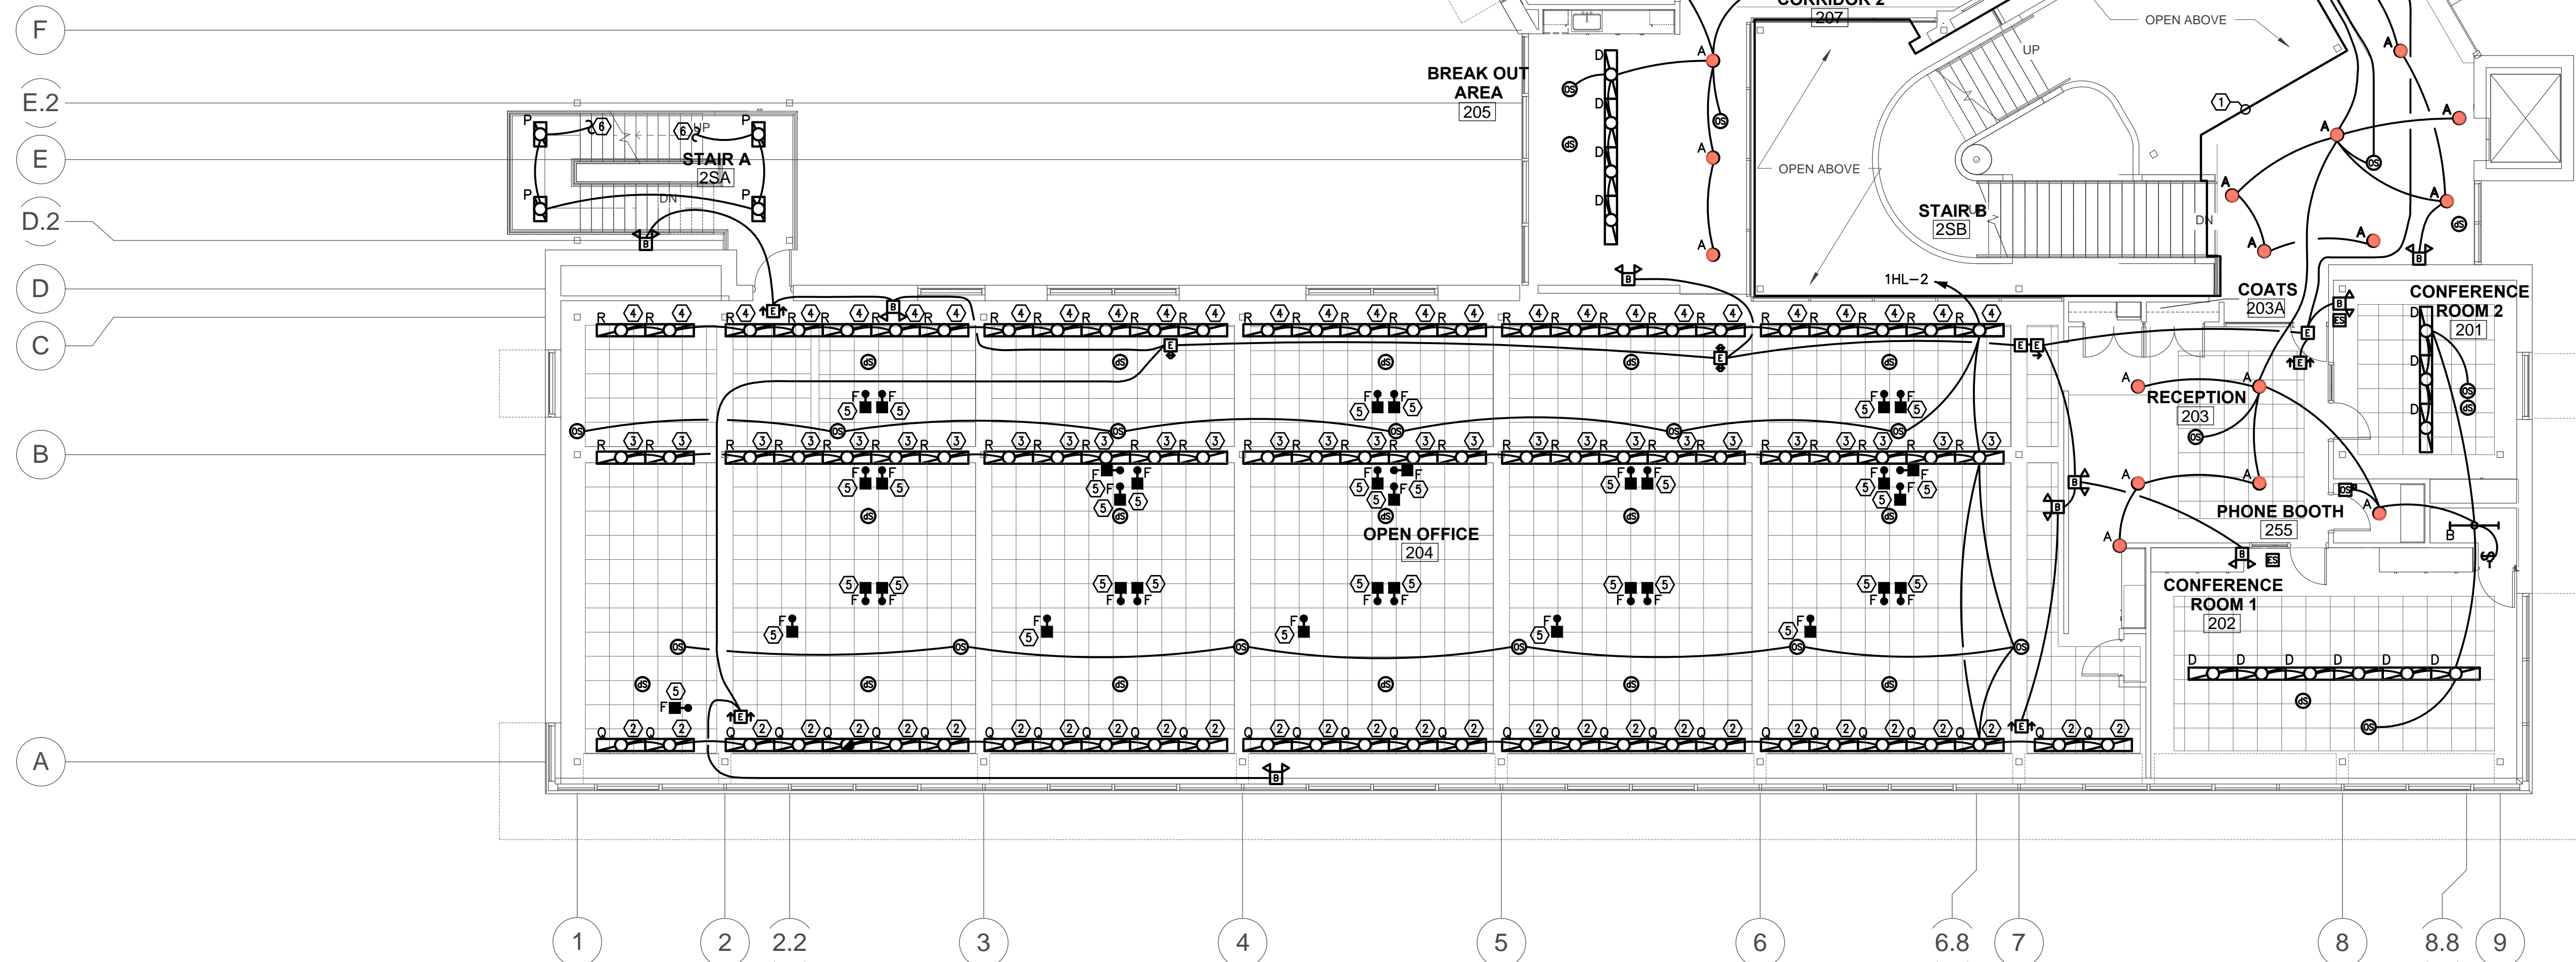

1 FLOOR PLAN - LIGHTING - CSL BUILDING - SECOND FLOOR
E201 1/8" = 1'-0"

Issued for: Pre-Bid; October 02, 2009